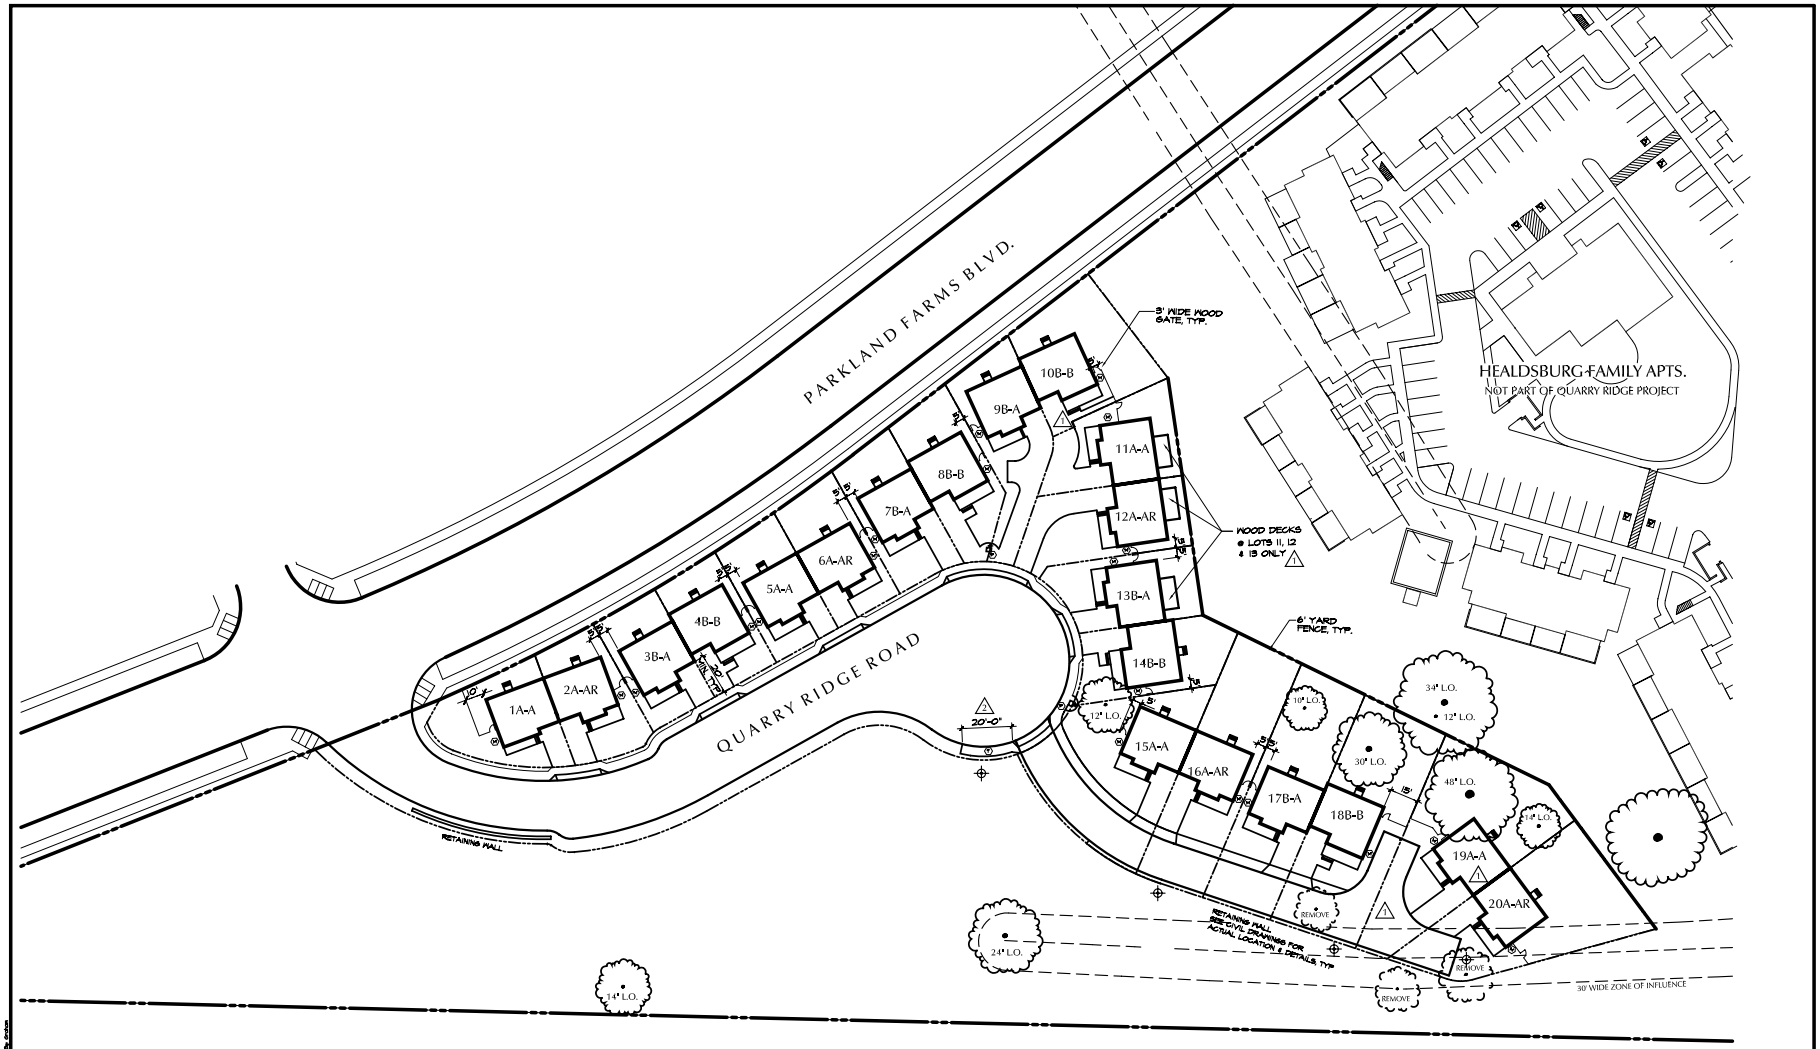

UNIT PLAN KEY

2A-AR
- LOT NUMBER
- INDICATES "REVERSED" PLAN
- FLOOR PLAN TYPE
- BUILDING TYPE

SITE PLAN NOTES:

1. SEE CIVIL DRAWINGS FOR RETAINING WALL, GRADING, DRAINAGE, STREET LIGHTS, UTILITY & RELATED INFO.
2. SEE LANDSCAPE DRAWINGS FOR FENCE PLANTING & IRRIGATION INFO INCLUDING ELECT/METER REQUIREMENTS
3. SEE SOILS REPORT FOR SITEWORK RECOMMENDATIONS & INFORMATION.

SITE LIGHTING KEY

12' HIGH AREA LIGHT. VERIFY LOCATIONS BASED ON FINAL STREET LIGHT LOCATIONS

SITE SYMBOL KEY

(M) ELECTRIC & GAS METERS. MOUNT ELECTRIC METER "EYE" AT 5'-0" ABOVE GRADE. PROVIDE ALL PG&E AND CODE REQ'D CLEARANCES. SEE ARCHITECTURAL PLANS AND EXTERIOR ELEVATIONS

(P) MAILBOXES

(T) TRASH COLLECTION AREA. 5" THK CONC SLAB WITH W/M. OVER ROCK BASE

NORTH

0 30 60

ARCHITECTURAL SITE PLAN 30'

REV	DATE	BY
1	PLAN CHECK CORR 5/18/99	
2	7/26/99	

TIERNEY/FIGUEIREDO
ARCHITECTS AIA
817 RUSSELL AVE. SUITE H SANTA ROSA, CA 95403
707.576.1537 FAX 576.1555
EMAIL:tfa@sonic.net WEB:http://www.sonic.net/tfa
TFA

These drawings & designs are the property of the Architects and no part thereof shall be copied or used for construction or any other work on project without the written consent of Tierney/Figueiredo Architects.

ARCHITECTURAL SITE PLAN

QUARRY RIDGE SELF HELP HOUSING

A BURBANK HOUSING DEVELOPMENT CORPORATION PROJECT
HEALDSBURG, CALIFORNIA

JOB NO.:	9803
DATE:	2/25/99
SCALE:	1" = 30'
DRAWN BY:	JBJ/FIG
CHECKED BY:	FIG
CAD FILE:	A1_1-SP

A1.1